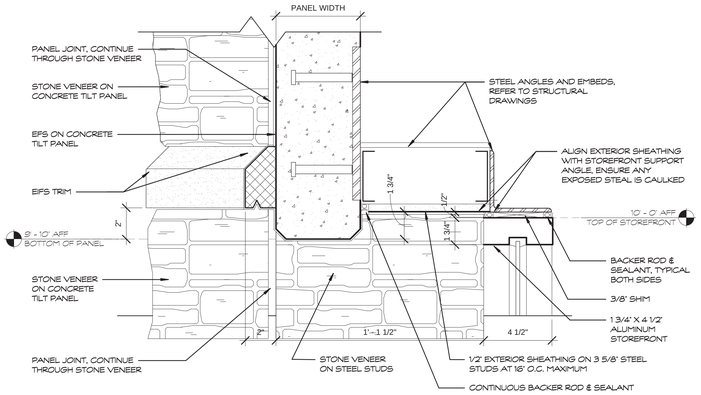

1 A7-1 SCALE 3" = 1'-0"

STOREFRONT - HEAD AT STUD WALL

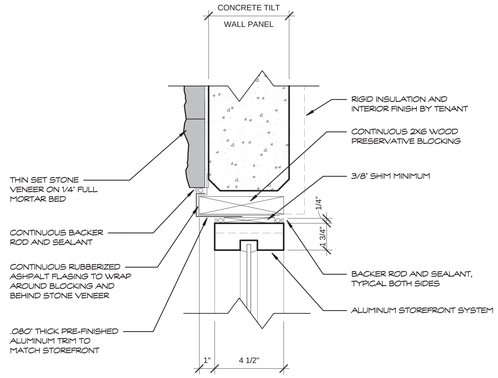

2 A7-1 SCALE 3" = 1'-0"

STOREFRONT - HEAD AT CONCRETE TILT PANEL

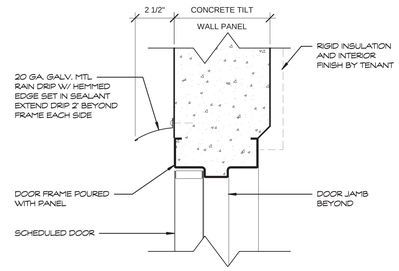

3 A7-1 SCALE 3" = 1'-0"

H.M. DOOR - HEAD

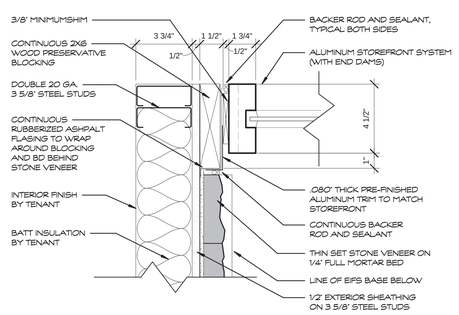

4 A7-1 SCALE 3" = 1'-0"

STOREFRONT - JAMB AT STUD WALL

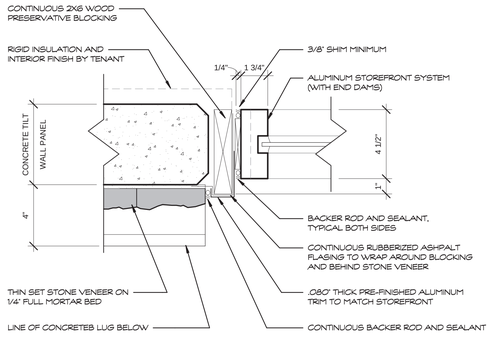

5 A7-1 SCALE 3" = 1'-0"

STOREFRONT - JAMB AT CONCRETE TILT PANEL

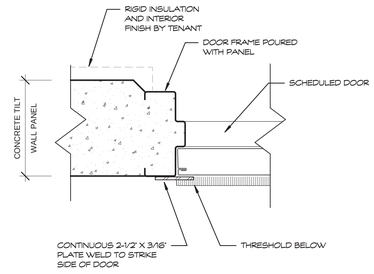

6 A7-1 SCALE 3" = 1'-0"

H.M. DOOR - JAMB

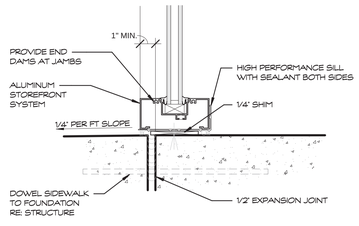

7 A7-1 SCALE 3" = 1'-0"

STOREFRONT - SILL

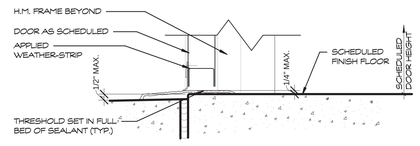

8 A7-1 SCALE 3" = 1'-0"

STOREFRONT DOOR - THRESHOLD

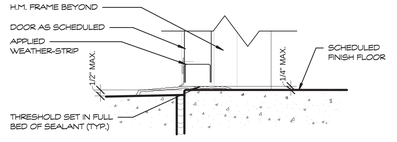

9 A7-1 SCALE 3" = 1'-0"

H.M. DOOR - THRESHOLD

Hermes Architects
Members A.I.A.
1177 West Loop South, Ste 500
Houston, Texas 77027
Tel. 713.785.3644
www.hermesarchitects.com
Houston : Dallas/Ft Worth

RECORD DRAWING
DATE: 02/16/09

THIS DRAWING HAS BEEN UPDATED BASED ON THE ARCHITECTS ORIGINAL DRAWINGS AND REPRESENTSTIONS OF THE CONTRACTORS PROJECT RECORDS AND IS BELIEVED TO BE AN ACCURATE REPRESENTATION OF THE COMPLETED WORK. FIELED VERIFY EXISTING CONDITIONS PRIOR TO ANY FUTURE WORK IN THE AREA REPRESENTED ON THE DRAWING. THIS IS AN INSTRUMENT OF SERVICE AND SHALL REMAIN THE PROPERTY OF THE ARCHITECT.

LEASE BUILDING AT CROSSROADS MALL

6906 Wesley Street
Greenville, Texas

Crossroads
GREENVILLE PROPERTIES LTD.
10850 WILCHIRE BLVD.
SUITE 1050
LOS ANGELES, CA 90024

DATE	08/15/08
PROJECT NO.	809500
DRAWN BY	Author
CHECKED BY	Checker

DOOR & WINDOW DETAILS

A7-1

_____ OF _____

© 2008

C:\Revit Models\Crossroads\A-HM-CM-AEP.rvt
2/24/2009 1:30:55 PM